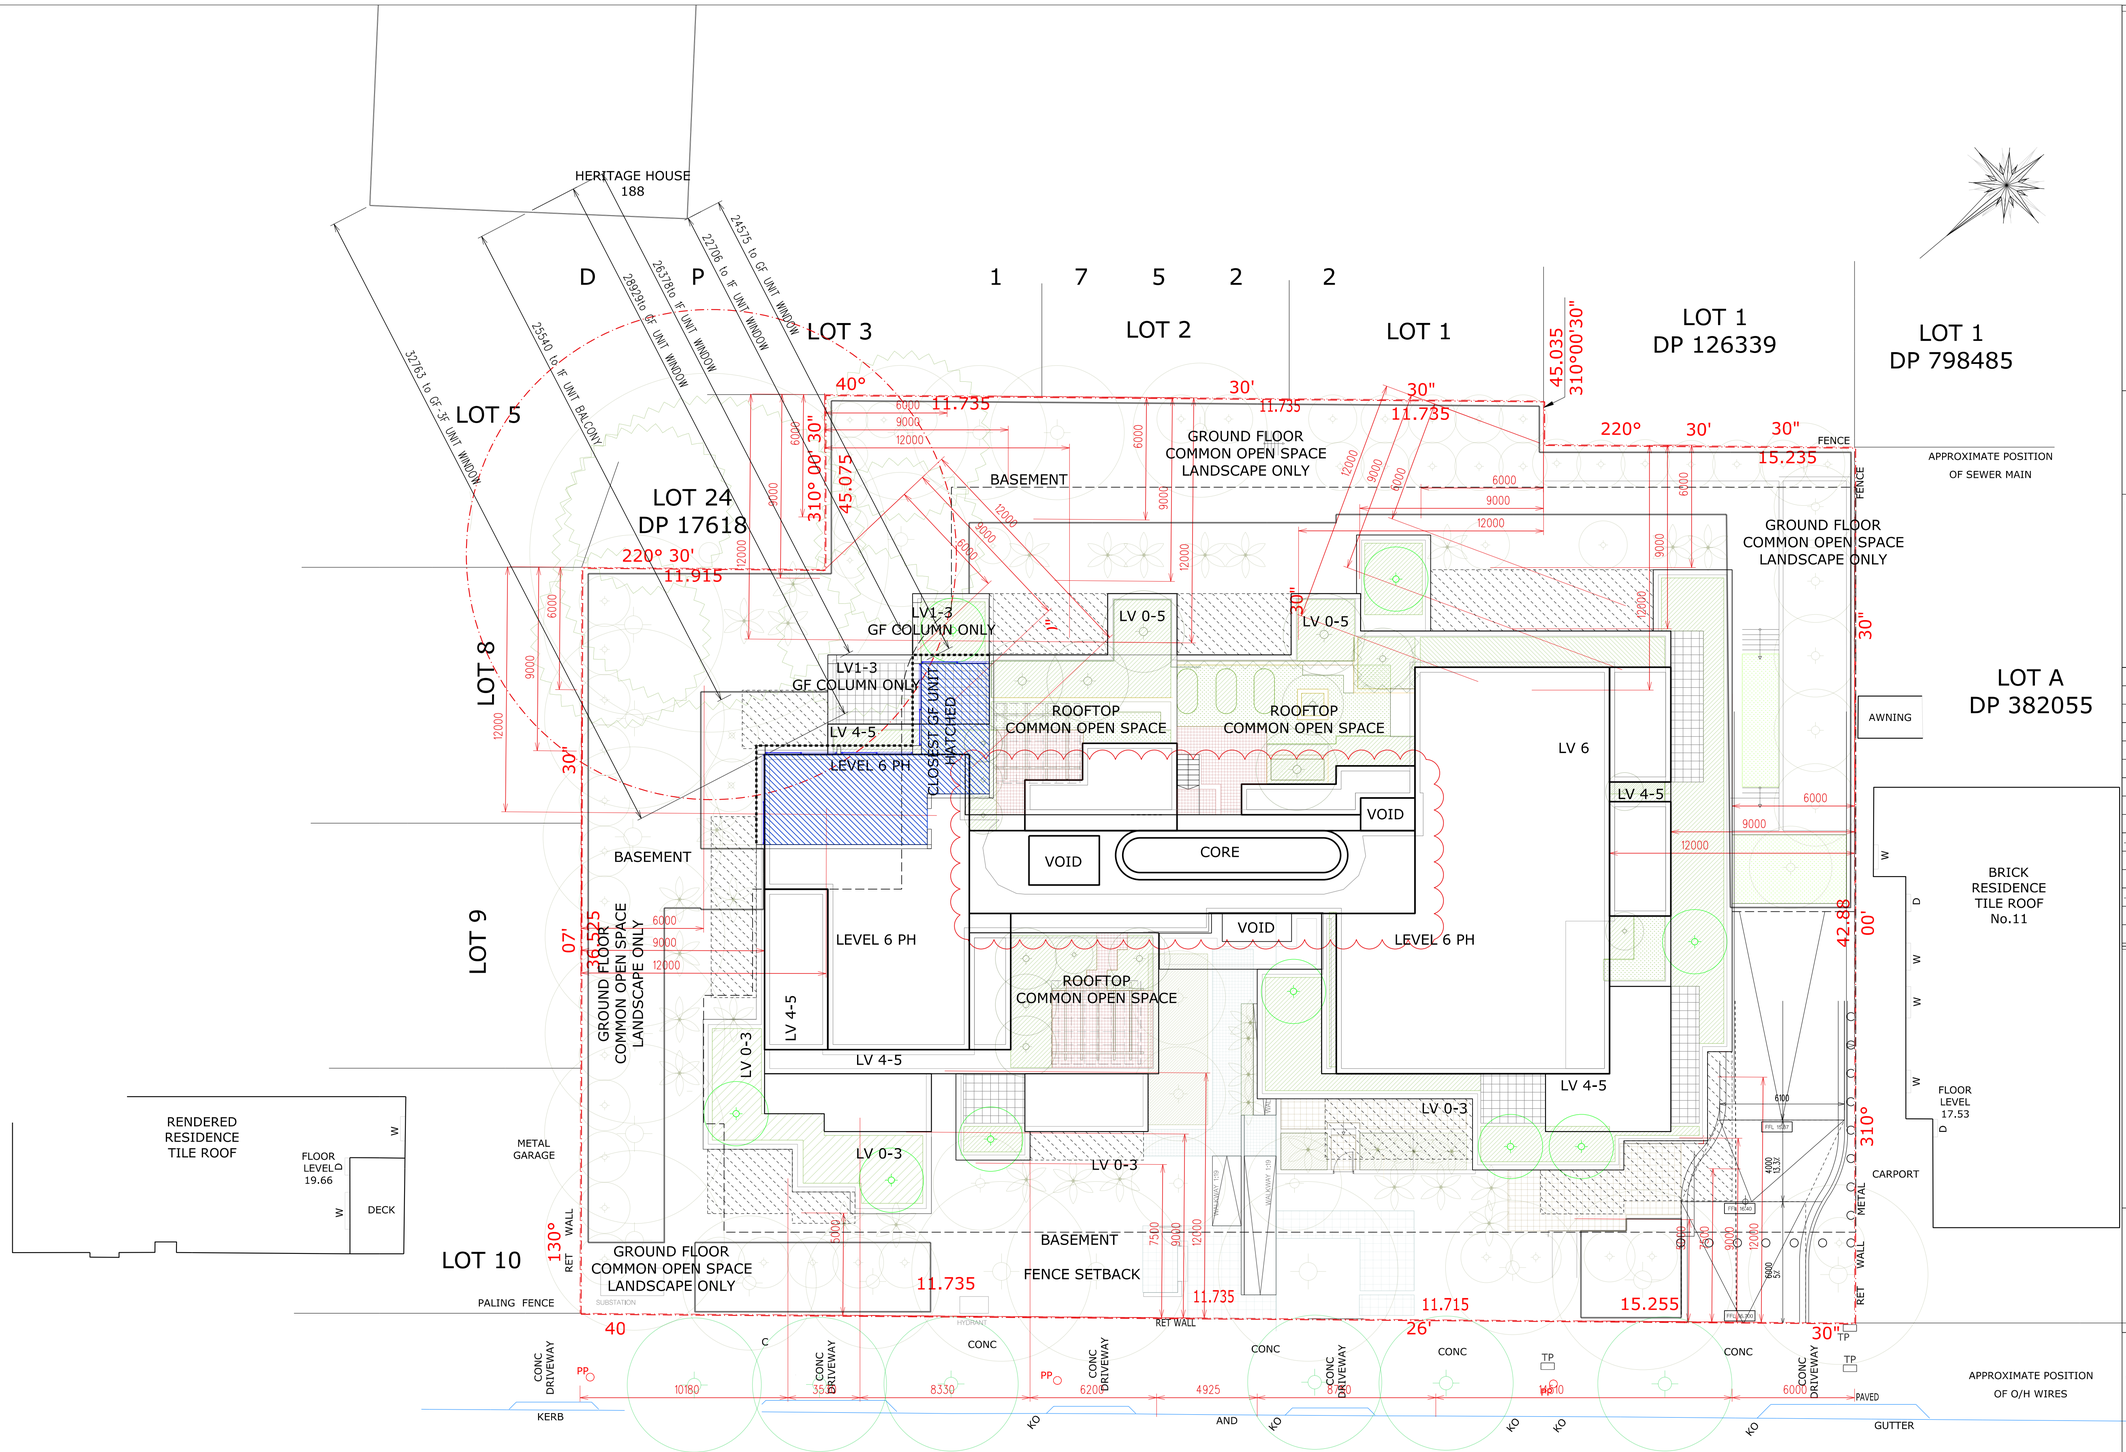

Note:

1. This drawing is copyright, the information shown remains the property of the Architect. The information shown is confidential and is for use only for the Wyuna st apartment. Any unauthorized use or copying of this document is prohibited.
2. Confirm all dimensions on site prior to ordering materials or commencing work.
3. Do not scale - ask.

Keyplan:

Main Legend

ISSUE	REVISION	DATE
A	ISSUE FOR S4.55 SUBMISSION	15.09.21
~~S5~~	~~ISSUE FOR SUBMISSION~~	~~15.06.21~~
S4	ISSUE FOR CONSULTANTS REVIEW	20.05.21
S3	ISSUE FOR client review	03.05.21
~~S2~~	~~ISSUE FOR SUBMISSION~~	~~29.03.21~~
S1	ISSUE FOR CLIENT REVIEW	10.03.21

PROJECT

APARTMENTS BUILDING

17 WYUNA ST BEVERLEY PARK 2217

THE INFORMATION CONTAINED IN THIS DOCUMENT IS FOR THE CLIENT ONLY. THE CLIENT SHALL MAKE ITS OWN ENQUIRIES, ANALYSIS AND CALCULATIONS AND FORM ITS OWN VIEWS IN RELATION TO THE USE OR DEVELOPMENT OF THE PROPERTY, INCLUDING THE APPLICATION OF LOCAL GOVERNMENT AND STATUTORY CONTROLS. IT IS ASSUMED THAT THE CLIENT WILL RELY ON ITS OWN EXPERTISE IN CONSIDERING THE INFORMATION.

CLIENT

WYUNA GROUP PTY LTD
SUITE 2/5-9 HUNTER STREET
PARRAMATTA NSW 2150
Attention: Ray Shalala
Ray.Shalala@developcorp.com.au
~~(02) 96~~35 3433

ARCHITECT

shiro architects
308/35 Buckingham St Surry Hills NSW 2010
Attention: Hiromi (Shiraishi) Lauren NSW 8848
hiromi@shiroarchites.com
0410 062 525

Member Australian Institute of Architects
shiro architects

Scale A1 1:150
0 3.75 7.5

DRAWING

SITE PLAN/ROOF PLAN

DRAWING NO.	ISSUE
A–04	A
DRAWN BY: XX	CHECKED BY: HL